

TUNNEL DUTY FREE RENOVATIONS

465 GOYEAU STREET
WINDSOR, ONTARIO

ARCHITECT
JP THOMSON ARCHITECTS LTD

CONTRACTOR
PCR CONTRACTING INC

PERFORATED PANEL DRAWINGS

ALUMINUM PANEL SYSTEM

ACMpanelworx SYSTEM PX-10 (DRY JOINT)
ALL JOINTS TO BE 5/8" UNLESS NOTED OTHERWISE

ALUMINUM PERFORATED PANELS
COLOUR TO MATCH - ANODIZED SILVER 38/91020



ALUMINUM PERFORATED PANELS
COLOUR TO MATCH - RAL 7021 BLACK GREY



NOTE: REFER TO SHEET 501 FOR ALUMINUM THICKNESS

GENERAL CONTRACTOR NOTE:

THESE DRAWINGS ARE BASED UPON OR INTERPRETATION OF THE CONTRACT DOCUMENTS.
UNLESS OTHERWISE INDICATED BELOW, RETURNING THESE DRAWINGS INDICATES APPROVAL
OF THE DETAILS AND VERIFICATION OF THE DIMENSIONS AND QUANTITIES SHOWN.

- DIMENSIONS AND DETAILS ARE VERIFIED, PROCEED WITH FABRICATION.
- DO NOT FABRICATE. WAIT FOR FIELD DIMENSIONS (WAITING FOR FIELD DIMENSIONS WILL DELAY DELIVERY)

CONTRACTORS SIGNATURE _____ DATE _____

LIST OF DRAWINGS:


- 101 = PANEL LAYOUT PLAN
- 201 - 202 = PANEL ELEVATIONS
- 301 = PANEL SECTIONS
- 401 - 403 = PANEL DETAILS
- 501 = TYPICAL PANEL PATTERNS

D&M GLASS ASSUMES NO RESPONSIBILITY AS TO MEASUREMENTS OR DETAILS AFFECTING ANY WORK BUT ITS OWN AND IS NOT RESPONSIBLE FOR ANY ERRORS CAUSED BY OTHER TRADES



No.	REVISION	BY	DATE
1	REVISIONS AS PER ARCH MARK-UPS	TJP	04.30.19

357 CROFT DRIVE TECUMSEH, ON N8N 2L9 TEL: (519) 735-0093 FAX: (519) 735-0075			
DRAWING NAME: COVER PAGE			
JOB NAME: TUNNEL DUTY FREE RENOVATIONS			
ADDRESS: 465 GOYEAU ST, WINDSOR, ONTARIO			
ARCHITECT: JP THOMSON ARCHITECTS LTD			
CONTRACTOR: PCR CONTRACTORS INC			
SCALE: NTS	DRAWN BY: TJP	CAD FILE:	SHEET No.
CHKD BY: RJM	DATE: 02.22.2019	JOB N.:	1187

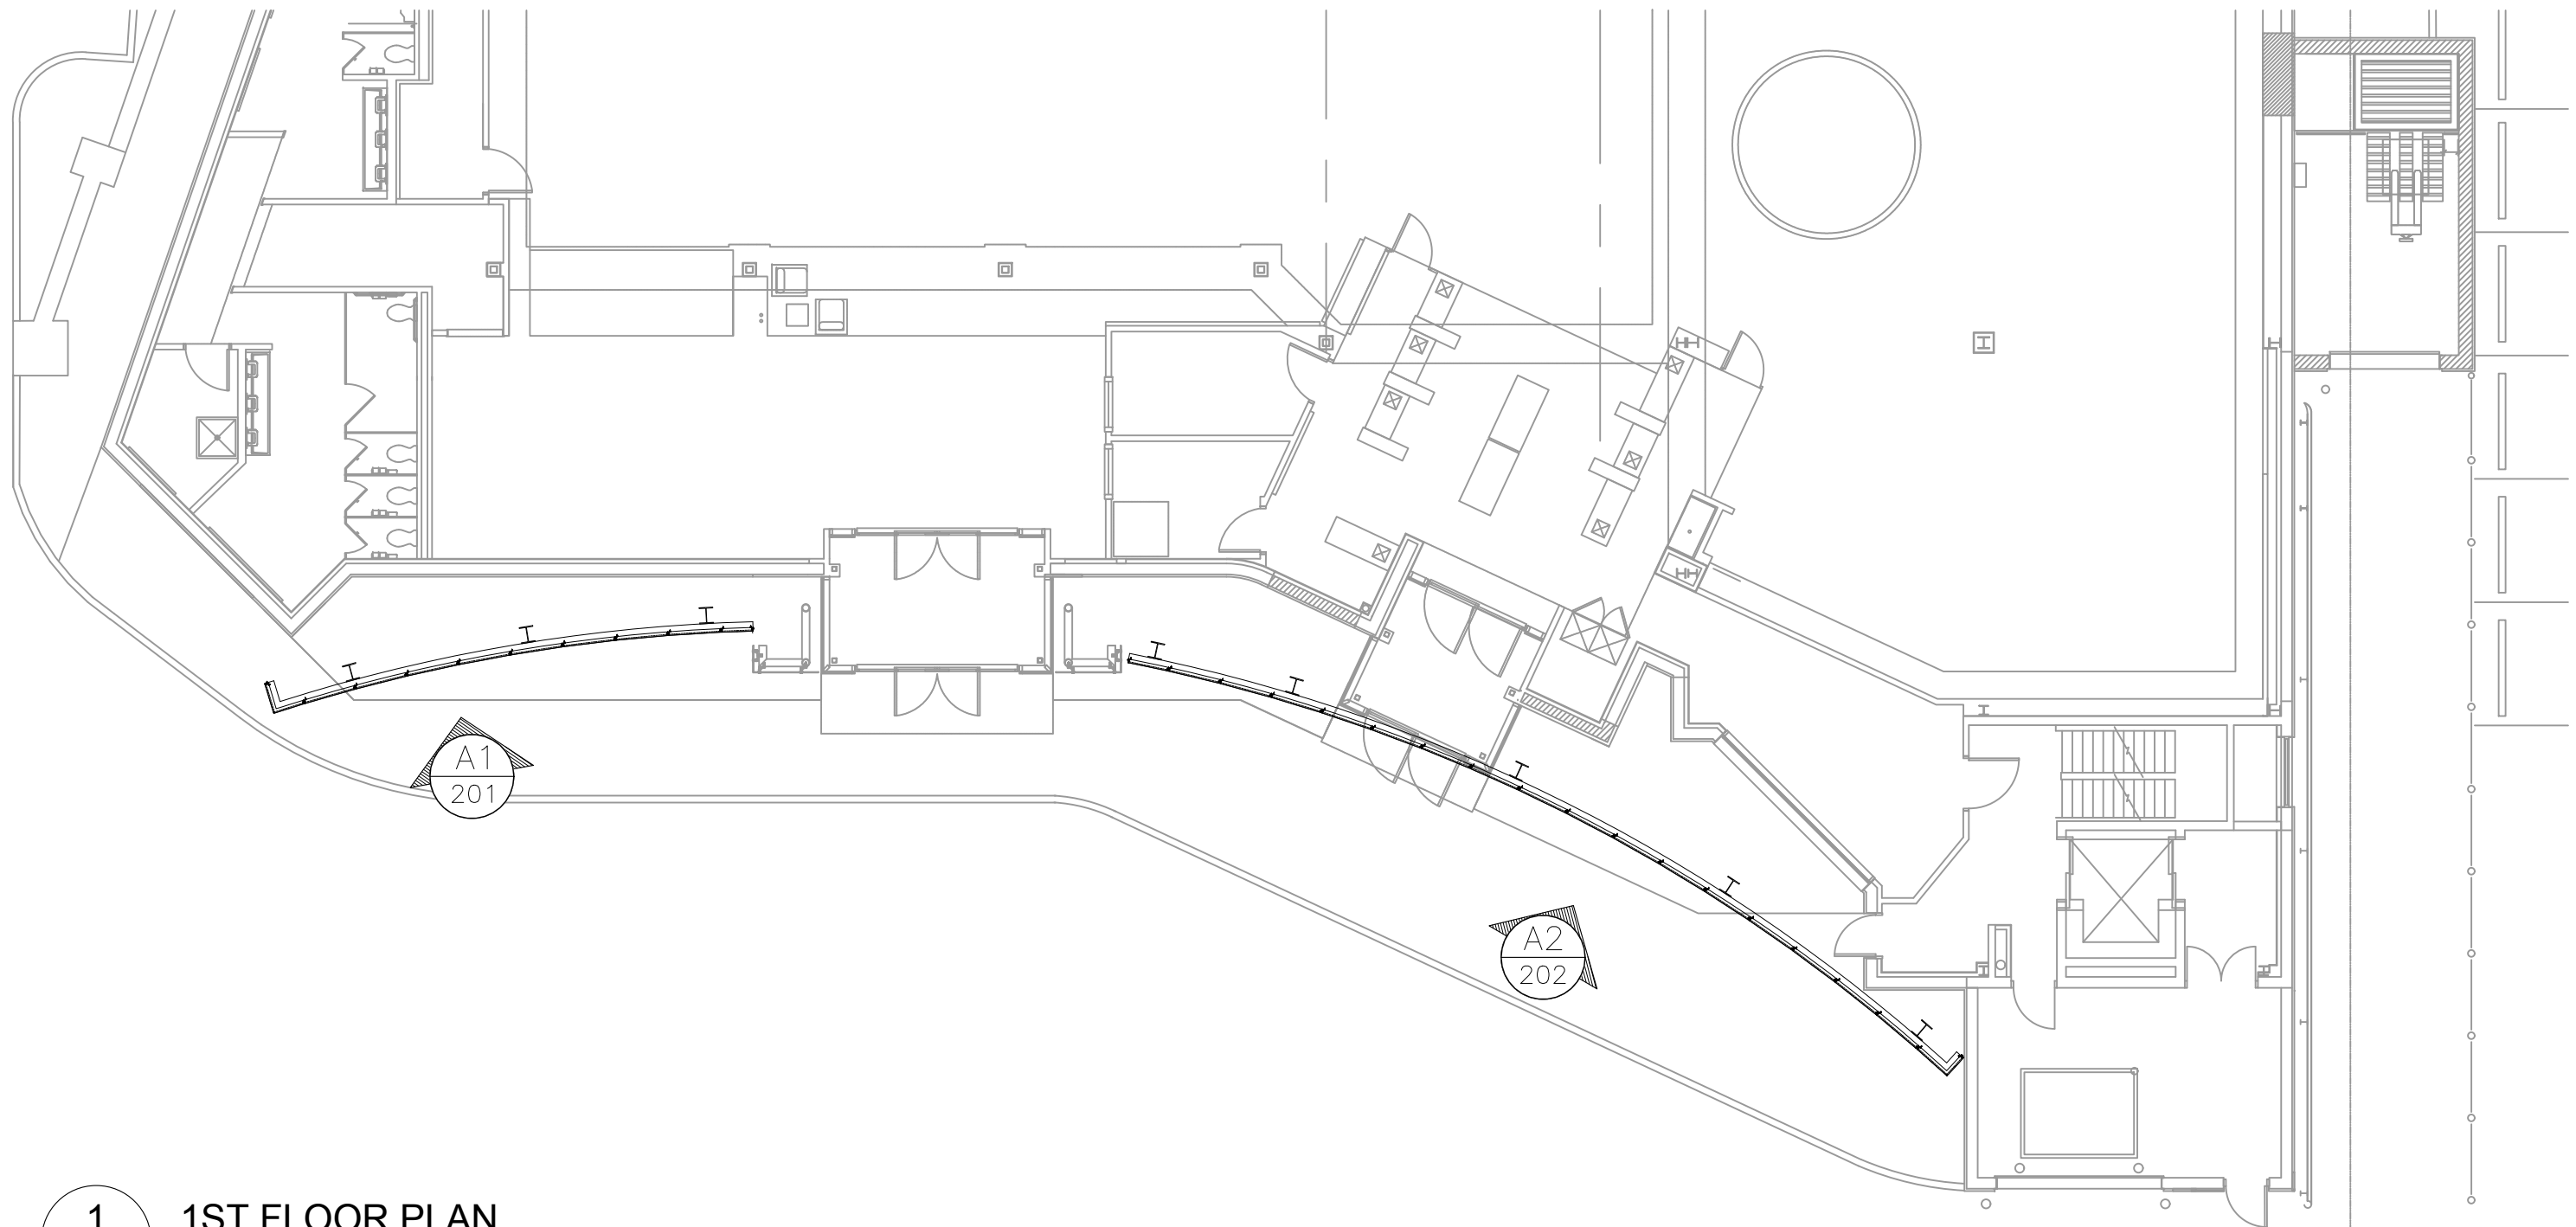


1
101
1ST FLOOR PLAN
 SCALE: NTS
 ARCH. REF: A2.05



No.	REVISION	BY	DATE
1	REVISIONS AS PER ARCH MARK-UPS	TJP	04.30.19

DMG			
architectural glass & metal			
<small>357 CROFT DRIVE TECUMSEH, ON N8N 2L9</small> <small>TEL: (519) 735-0093 FAX: (519) 735-0075</small>			
DRAWING NAME: PANEL LAYOUT PLAN			
JOB NAME: TUNNEL DUTY FREE RENOVATIONS			
ADDRESS: 465 GOYEAU ST, WINDSOR, ONTARIO			
ARCHITECT: JP THOMSON ARCHITECTS LTD			
CONTRACTOR: PCR CONTRACTORS INC			
SCALE: NTS	DRAWN BY: TJP	CAD FILE:	SHEET No.
CHKD BY: RJM	DATE: 02.22.2019	JOB N.: 1187	101

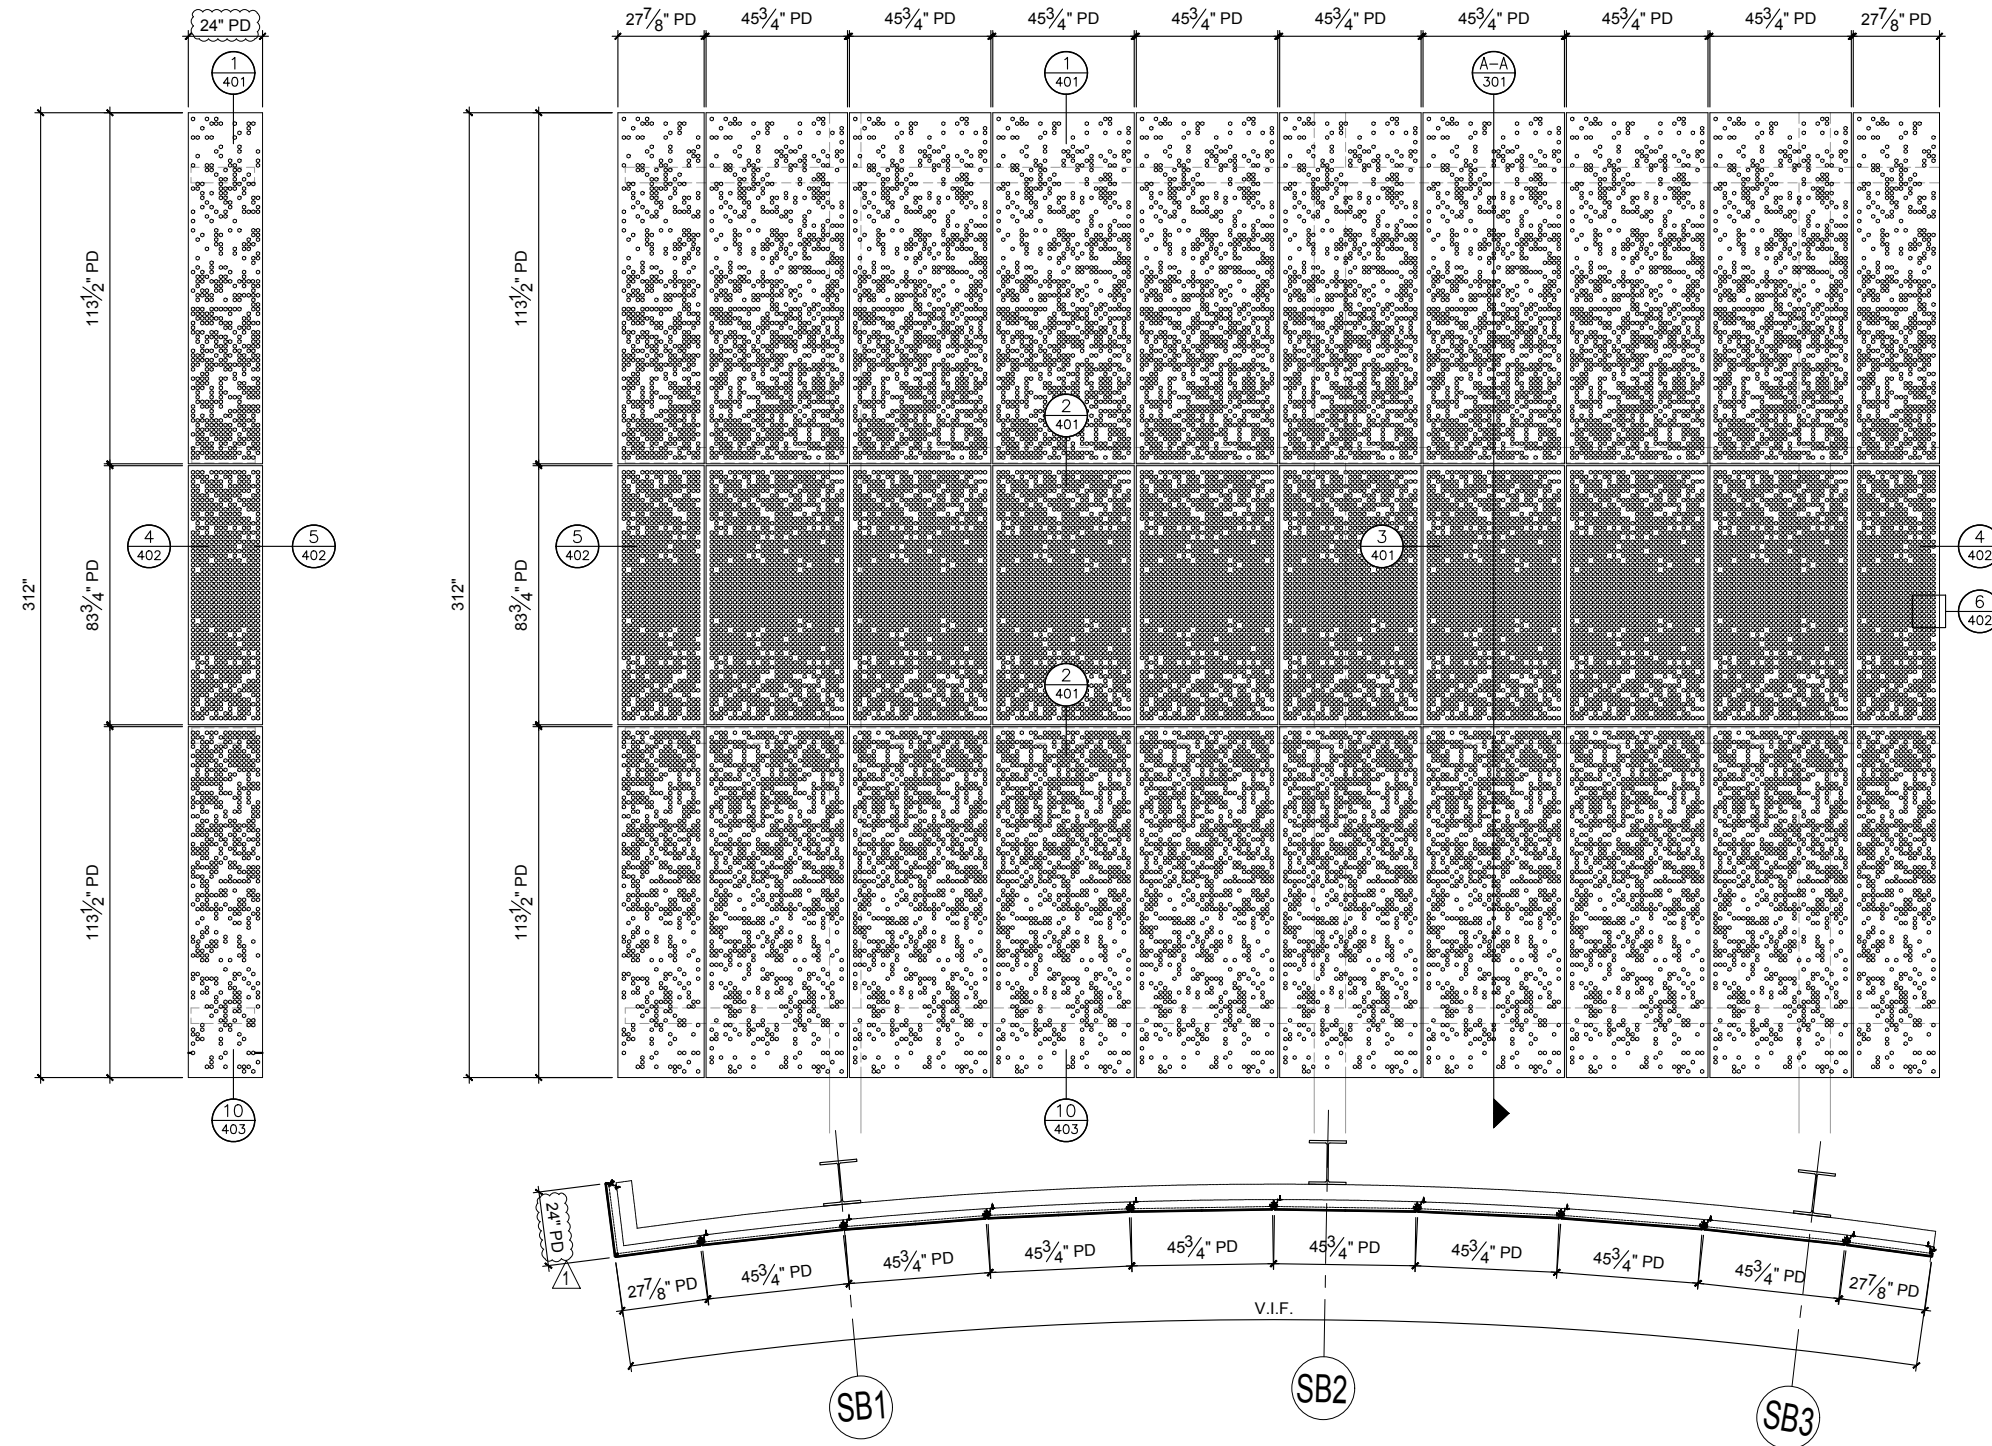


A1 DECORATIVE PANEL WALL
SCALE: 3/16" = 1'-0"


ALUMINUM PERFORATED PANELS
COLOUR TO MATCH - ANODIZED SILVER 38/91020

ALUMINUM PERFORATED PANELS
COLOUR TO MATCH - RAL 7021 BLACK GREY

NOTE: REFER TO SHEET 501 FOR ALUMINUM THICKNESS

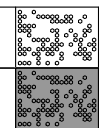

No.	REVISION	BY	DATE
1	REVISIONS AS PER ARCH MARK-UPS	TJP	04.30.19


 357 CROFT DRIVE
 TECUMSEH, ON N8N 2L9
 TEL: (519) 735-0093
 FAX: (519) 735-0075

DRAWING NAME: PANEL ELEVATIONS

JOB NAME: TUNNEL DUTY FREE RENOVATIONS


ADDRESS: 465 GOYEAU ST, WINDSOR, ONTARIO

ARCHITECT: JP THOMSON ARCHITECTS LTD

CONTRACTOR: PCR CONTRACTORS INC

SCALE: 3/16"=1'-0" DRAWN BY: TJP CAD FILE: SHEET No.

CHKD BY: RJM DATE: 02.22.2019 JOB N.: 1187 201

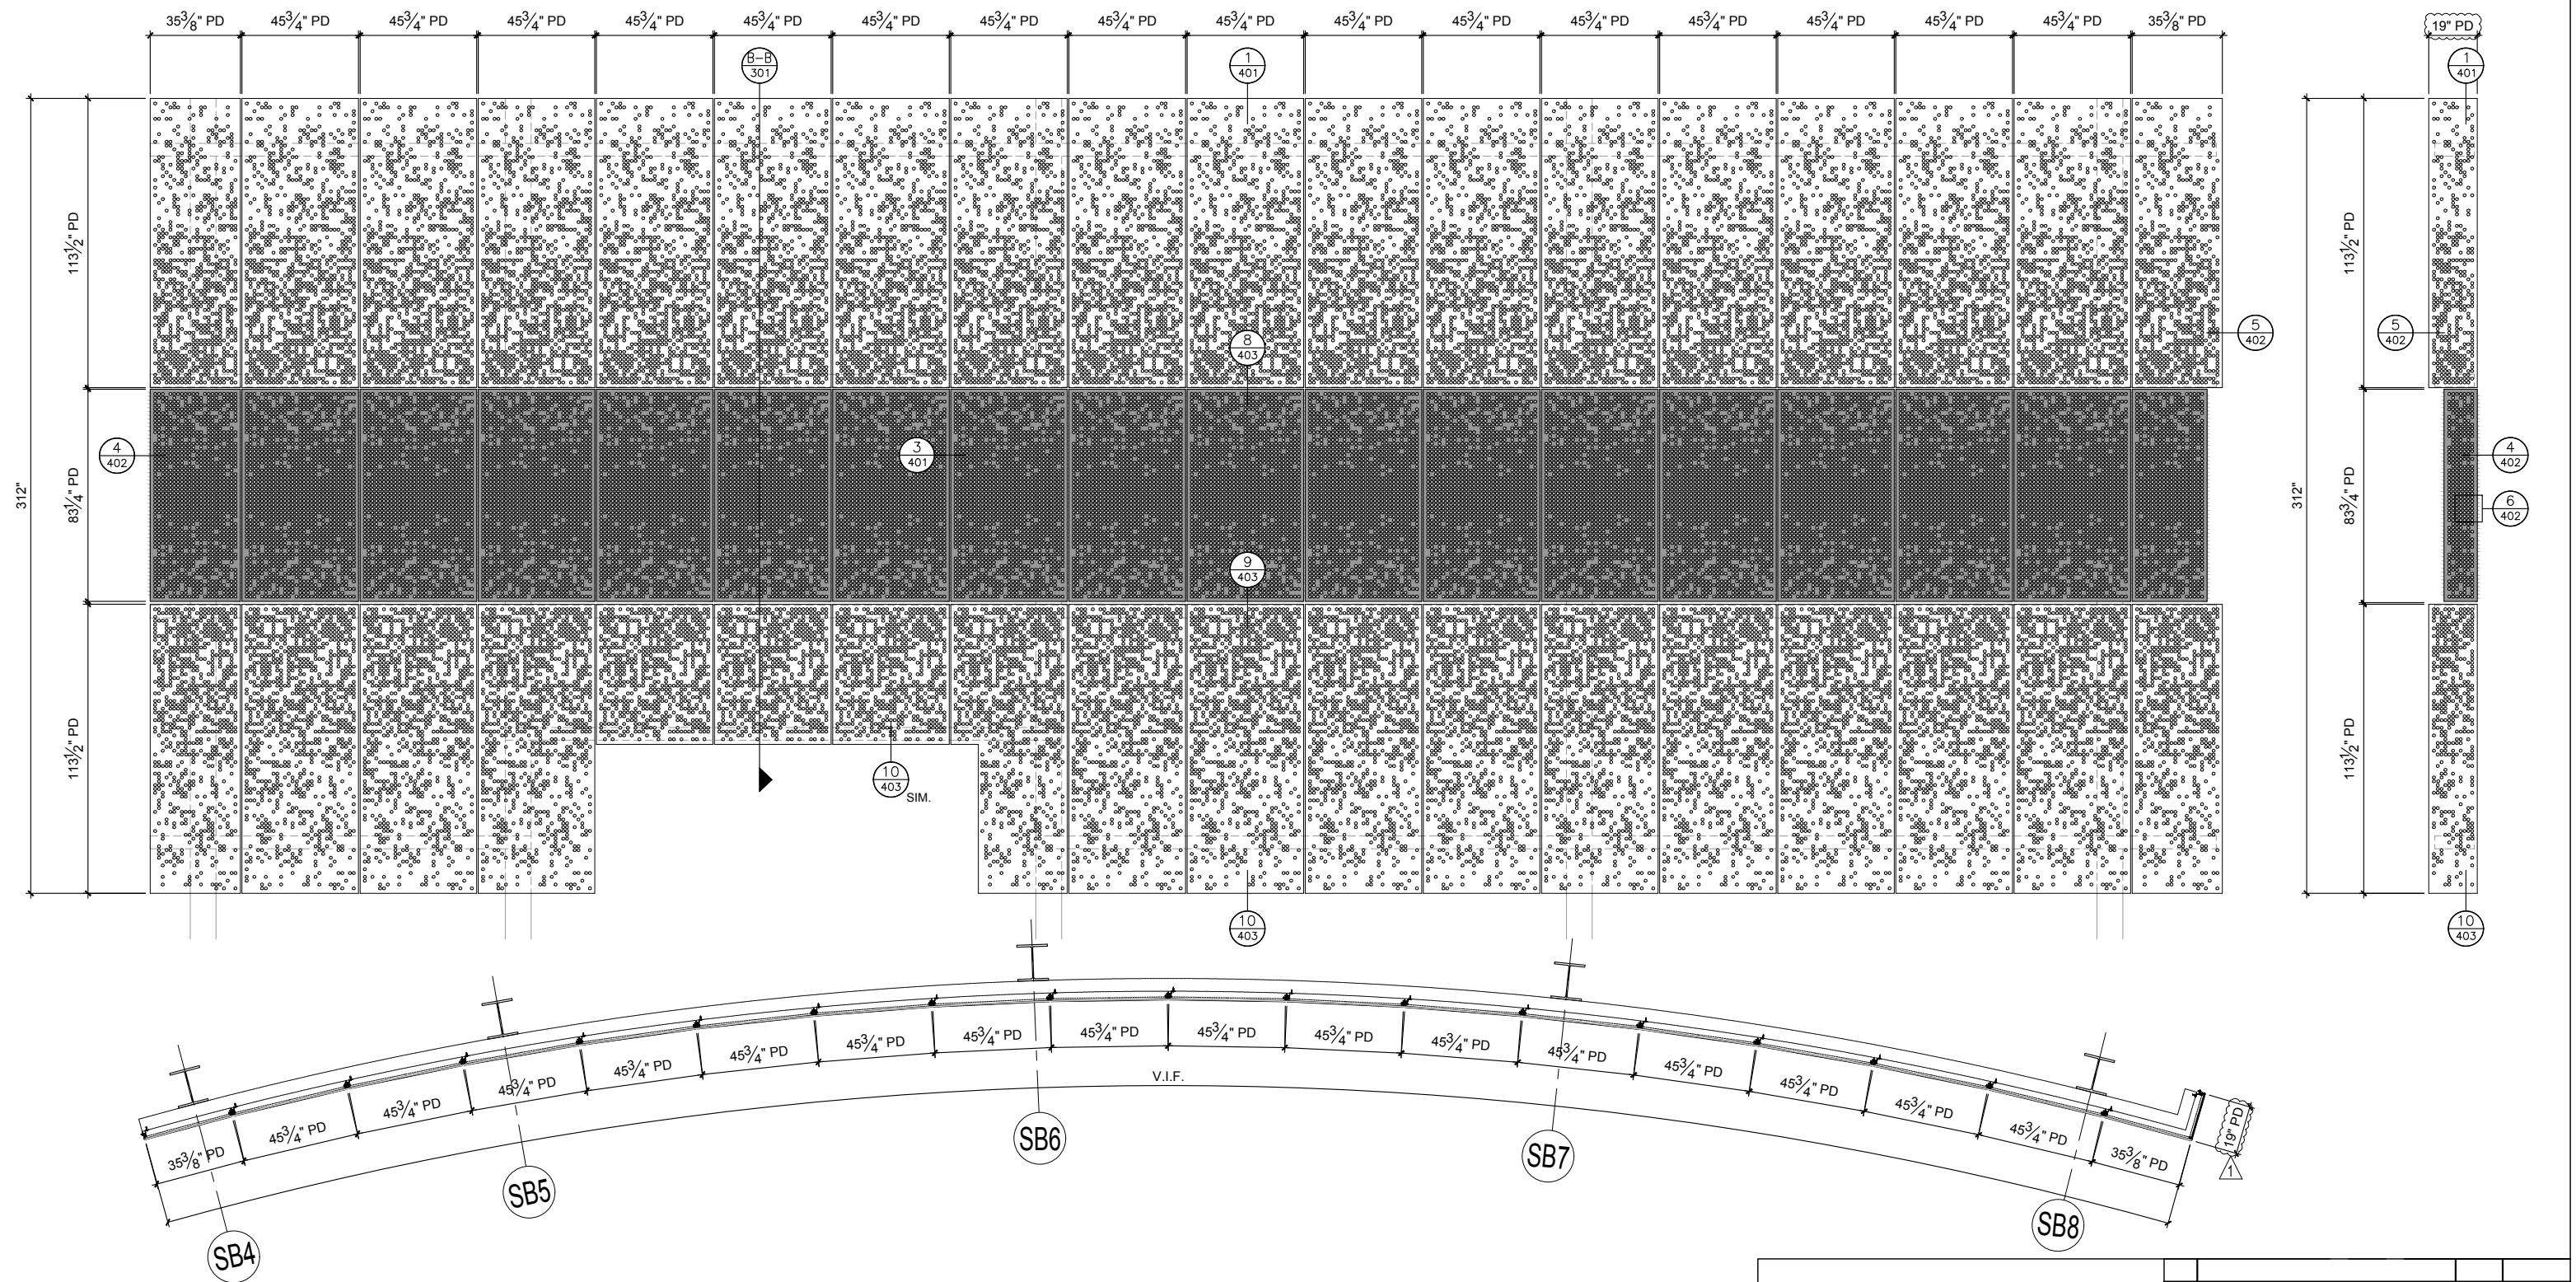


A2 DECORATIVE PANEL WALL
202 SCALE: 3/16" = 1'-0"

ALUMINUM PERFORATED PANELS
COLOUR TO MATCH - ANODIZED SILVER 38/91020

ALUMINUM PERFORATED PANELS
COLOUR TO MATCH - RAL 7021 BLACK GREY

NOTE: REFER TO SHEET 501 FOR ALUMINUM THICKNESS

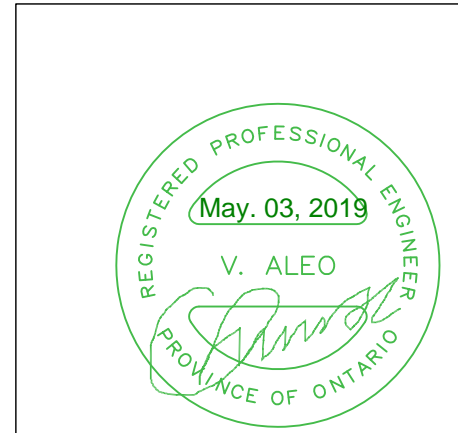

No.	REVISION	BY	DATE
1	REVISIONS AS PER ARCH MARK-UPS	TJP	04.30.19

DMG
architectural glass & metal

357 CROFT DRIVE
TECUMSEH, ON N8N 2L9 TEL: (519) 735-0093
FAX: (519) 735-0075

DRAWING NAME: PANEL ELEVATIONS

JOB NAME: TUNNEL DUTY FREE RENOVATIONS



ADDRESS: 465 GOYEAU ST, WINDSOR, ONTARIO

ARCHITECT: JP THOMSON ARCHITECTS LTD

CONTRACTOR: PCR CONTRACTORS INC

SCALE: 3/16"=1'-0" DRAWN BY: TJP CAD FILE: SHEET No.

CHKD BY: RJM DATE: 02.22.2019 JOB N.: 1187 202

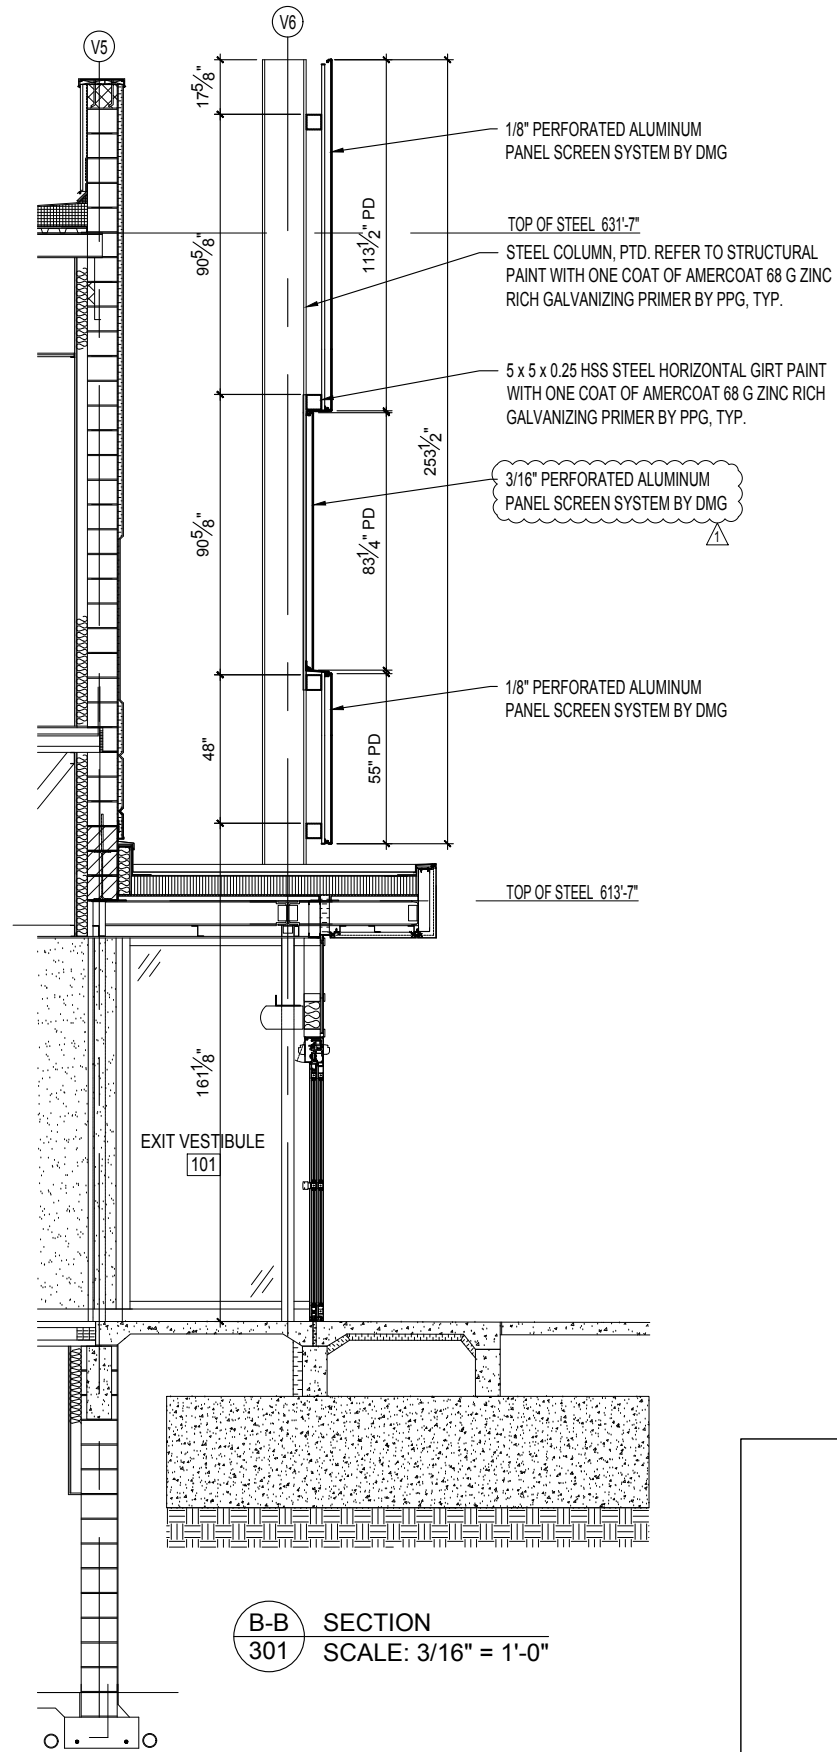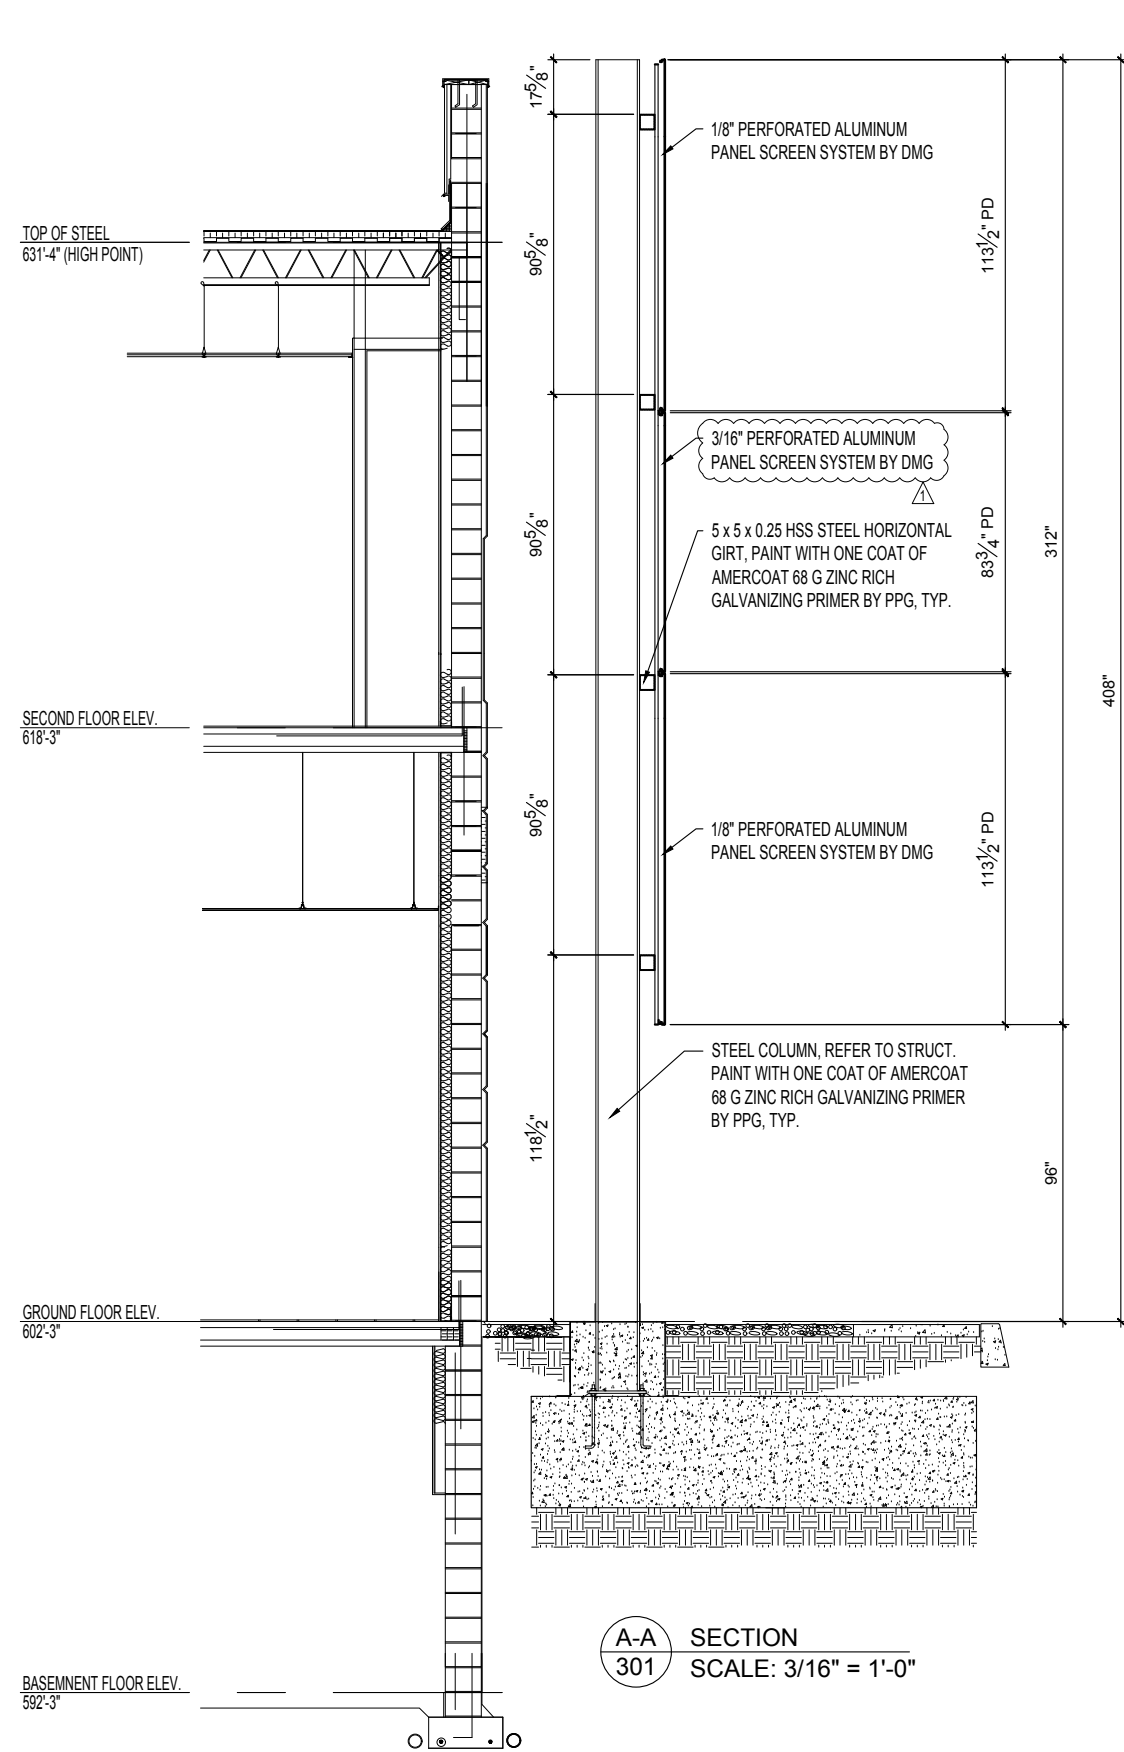

1	REVISIONS AS PER ARCH MARK-UPS	TJP	04.30.19
No.	REVISION	BY	DATE

DMG
architectural glass & metal

357 CROFT DRIVE
TECUMSEH, ON N8N 2L9 TEL: (519) 735-0093
FAX: (519) 735-0075

DRAWING NAME: **PANEL SECTIONS**

JOB NAME: TUNNEL DUTY FREE RENOVATIONS

ADDRESS: 465 GOYEAU ST, WINDSOR, ONTARIO


ARCHITECT: JP THOMSON ARCHITECTS LTD

CONTRACTOR: PCR CONTRACTORS INC


SCALE: 3/16"=1'-0" DRAWN BY: TJP CAD FILE: SHEET No. 301

CHKD BY: RJM DATE: 02.22.2019 JOB N.: 1187


V6

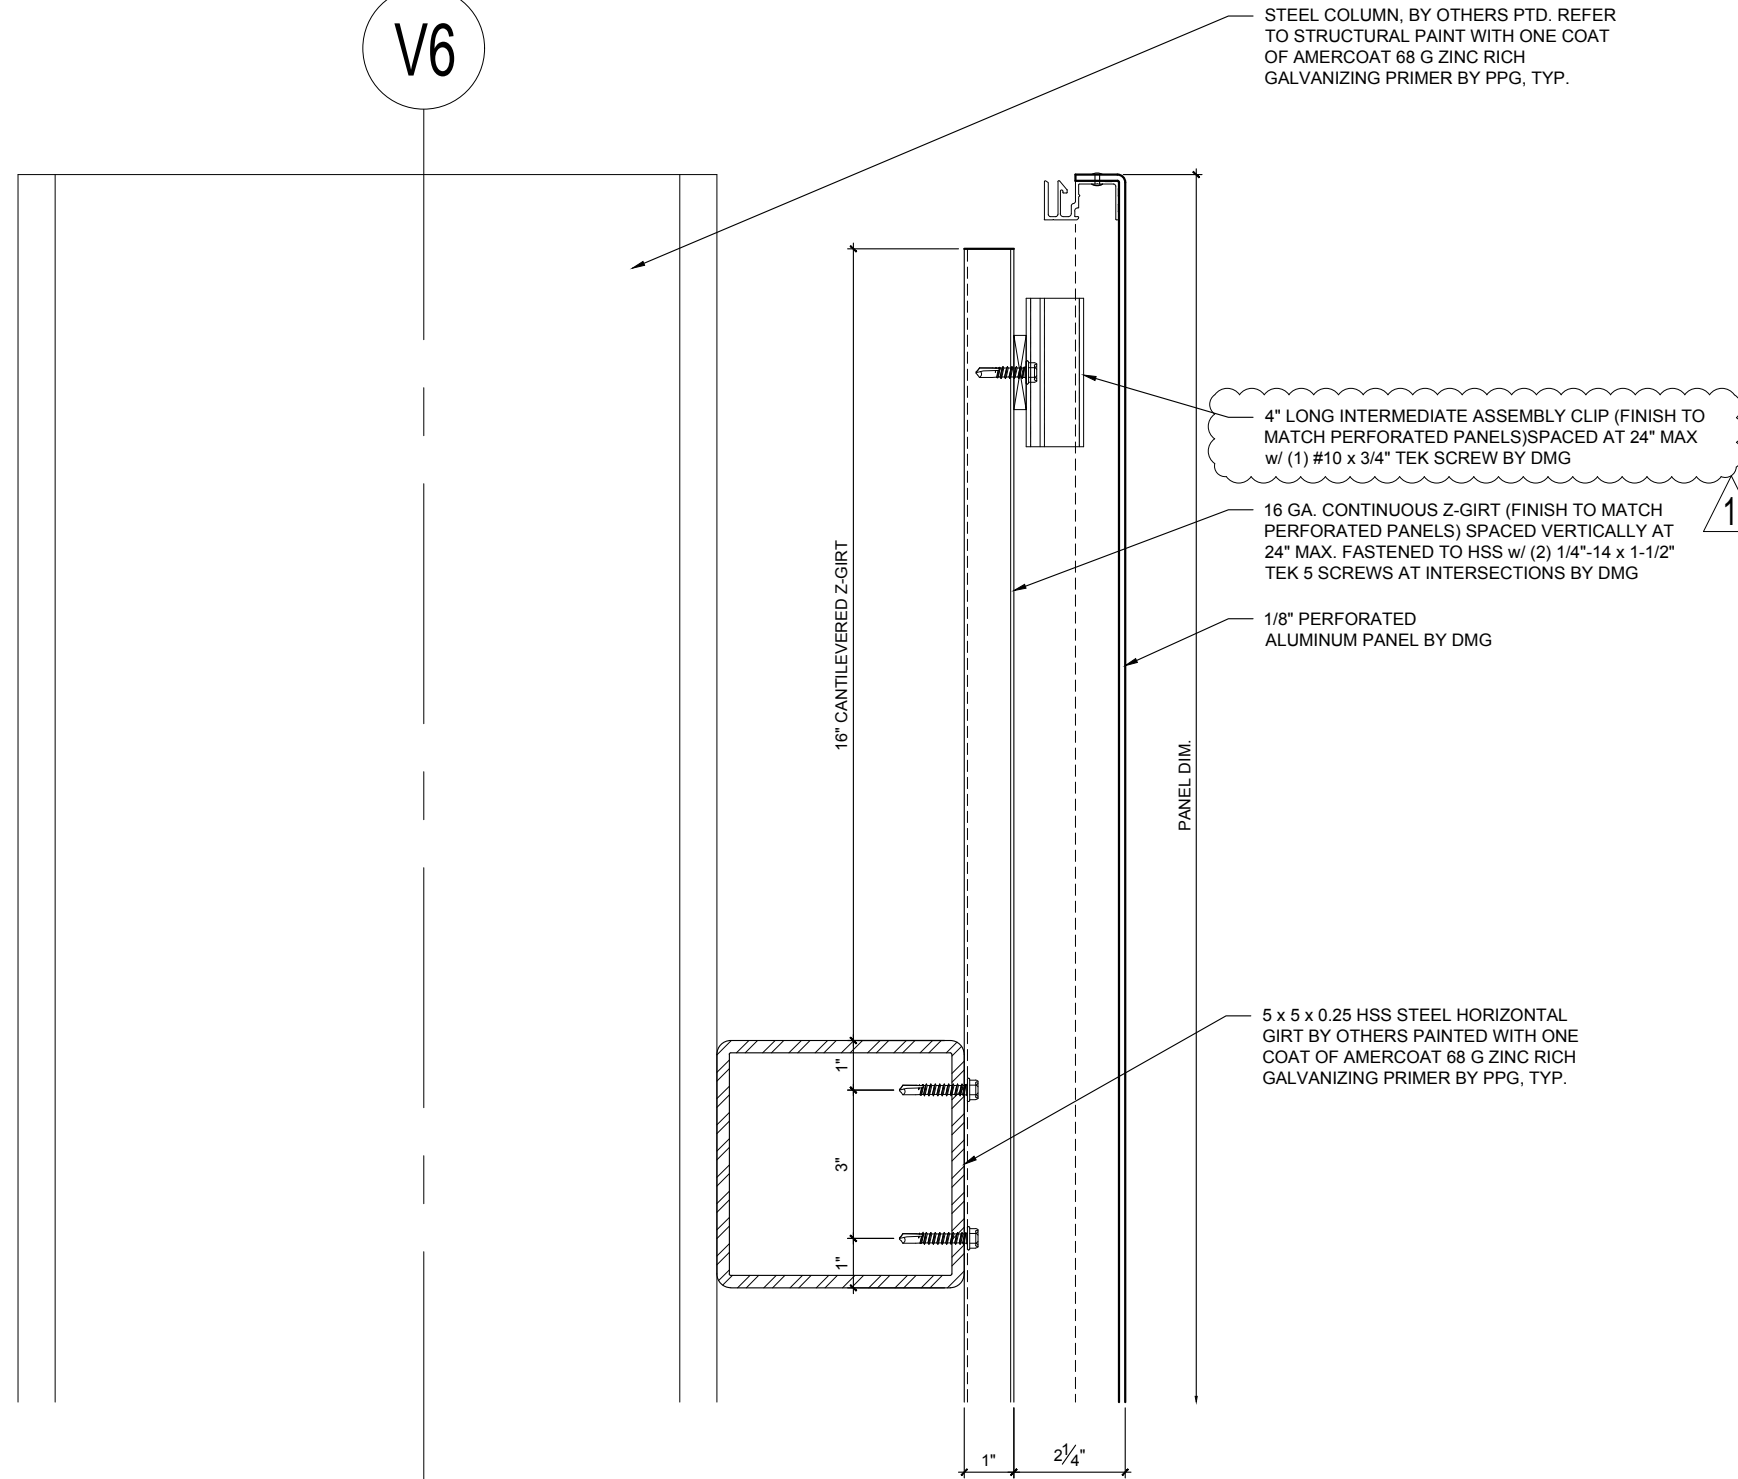

1 TOP EDGE OF PANEL
401 SCALE: 3" = 1'-0"

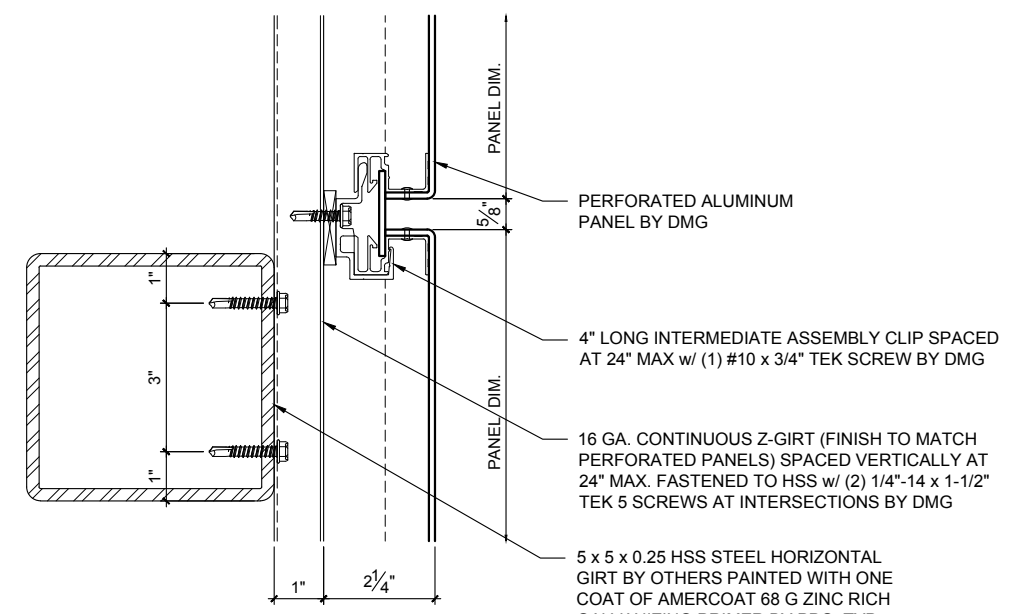


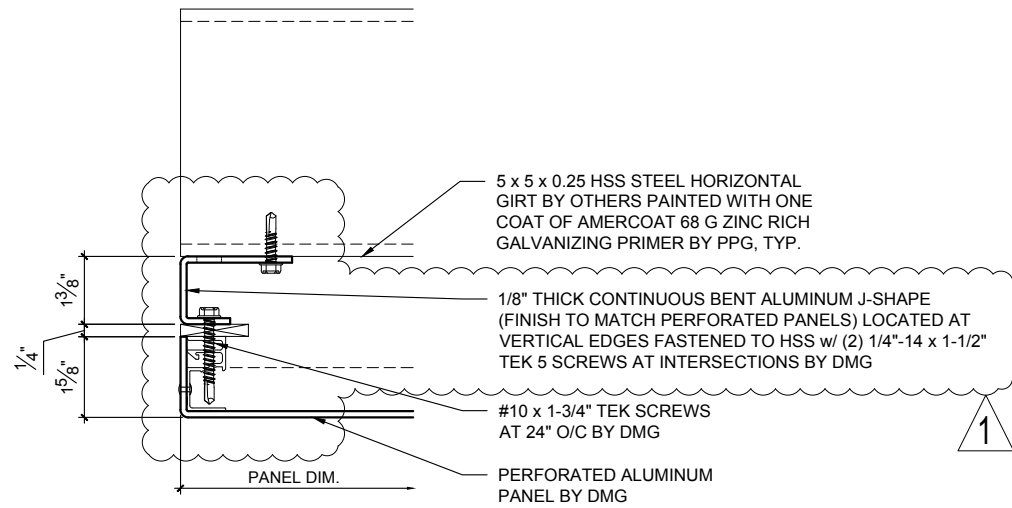
2 TYP. DRY JOINT DETAIL
401 SCALE: 3" = 1'-0"

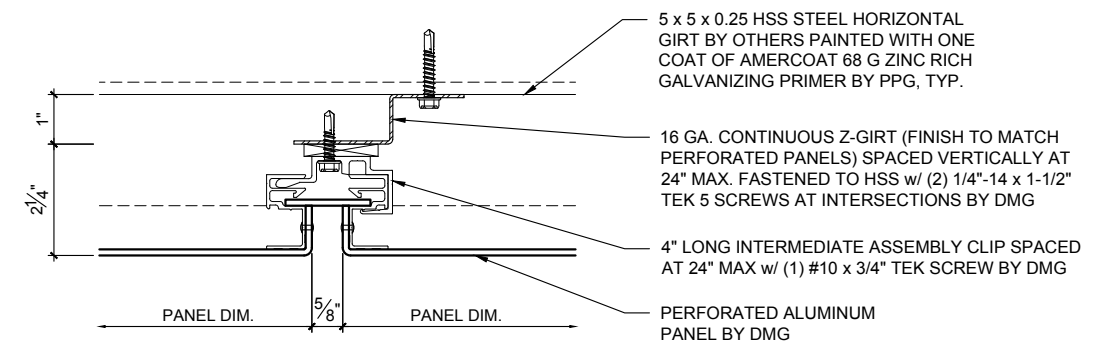


3 TYP. CONNECTION- VERT. JT. @ HORIZ. STEEL
401 SCALE: 3" = 1'-0"




1	REVISIONS AS PER ARCH MARK-UPS	TJP	04.30.19
No.	REVISION	BY	DATE
			
<small>357 CROFT DRIVE TECUMSEH, ON N8N 2L9 TEL: (519) 735-0093 FAX: (519) 735-0075</small>			
DRAWING NAME: PANEL DETAILS			
JOB NAME: TUNNEL DUTY FREE RENOVATIONS			
ADDRESS: 465 GOYEAU ST, WINDSOR, ONTARIO			
ARCHITECT: JP THOMSON ARCHITECTS LTD			
CONTRACTOR: PCR CONTRACTORS INC			
SCALE: 3/16"=1'-0"	DRAWN BY: TJP	CAD FILE:	SHEET No.
CHKD BY: RJM	DATE: 02.22.2019	JOB N.: 1187	401




4 EDGE OF PANEL
402 SCALE: 3" = 1'-0"

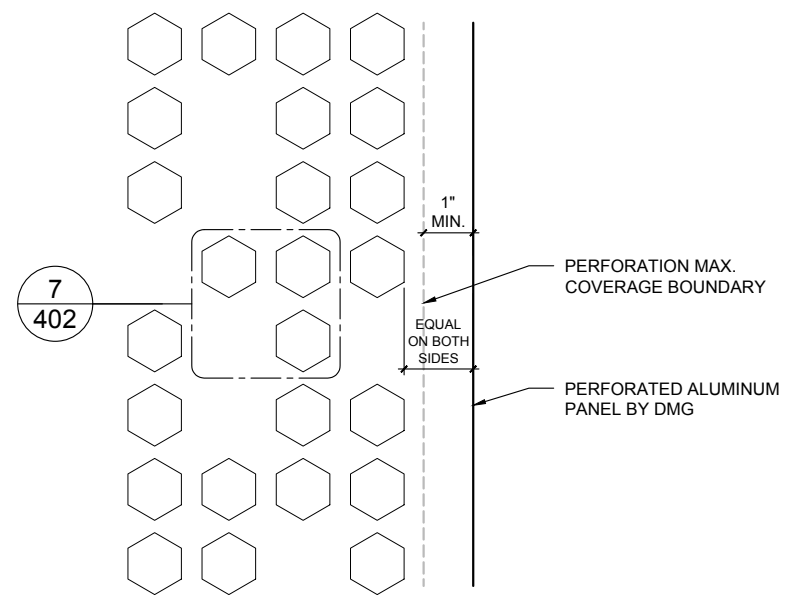

6 EDGE OF PANEL
402 SCALE: 3" = 1'-0"

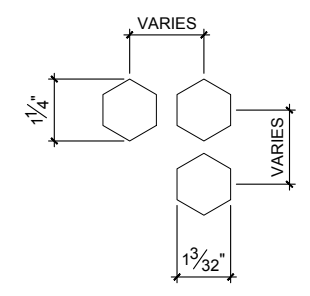

7 CUSTOM HEXOGONAL HOLES ENLARGED
402 SCALE: 3" = 1'-0"

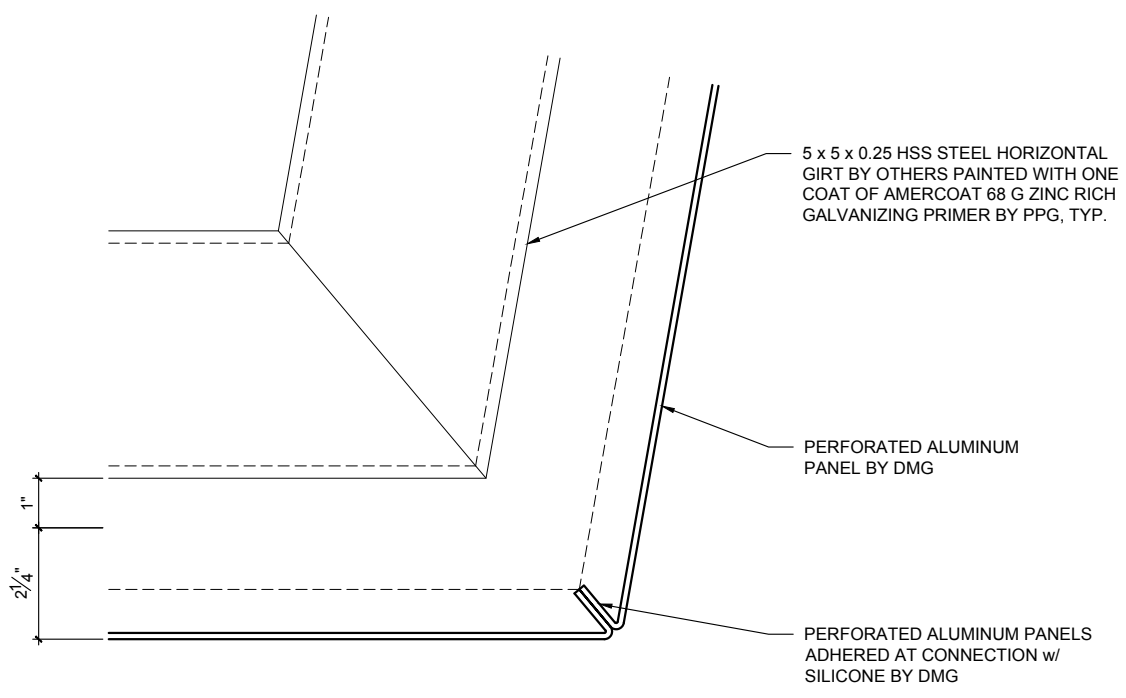

5 OUTSIDE CORNER DETAIL
402 SCALE: 3"=1'-0"



No.	REVISION	BY	DATE
1	REVISIONS AS PER ARCH MARK-UPS	TJP	04.30.19

DMG
architectural glass & metal

357 CROFT DRIVE
TECUMSEH, ON N8N 2L9 TEL: (519) 735-0093
FAX: (519) 735-0075

DRAWING NAME: PANEL DETAILS

JOB NAME: TUNNEL DUTY FREE RENOVATIONS


ADDRESS: 465 GOYEAU ST, WINDSOR, ONTARIO

ARCHITECT: JP THOMSON ARCHITECTS LTD


CONTRACTOR: PCR CONTRACTORS INC

SCALE: 3/16"=1'-0" DRAWN BY: TJP CAD FILE: SHEET No.


CHKD BY: RJM DATE: 02.22.2019 JOB N.: 1187 402

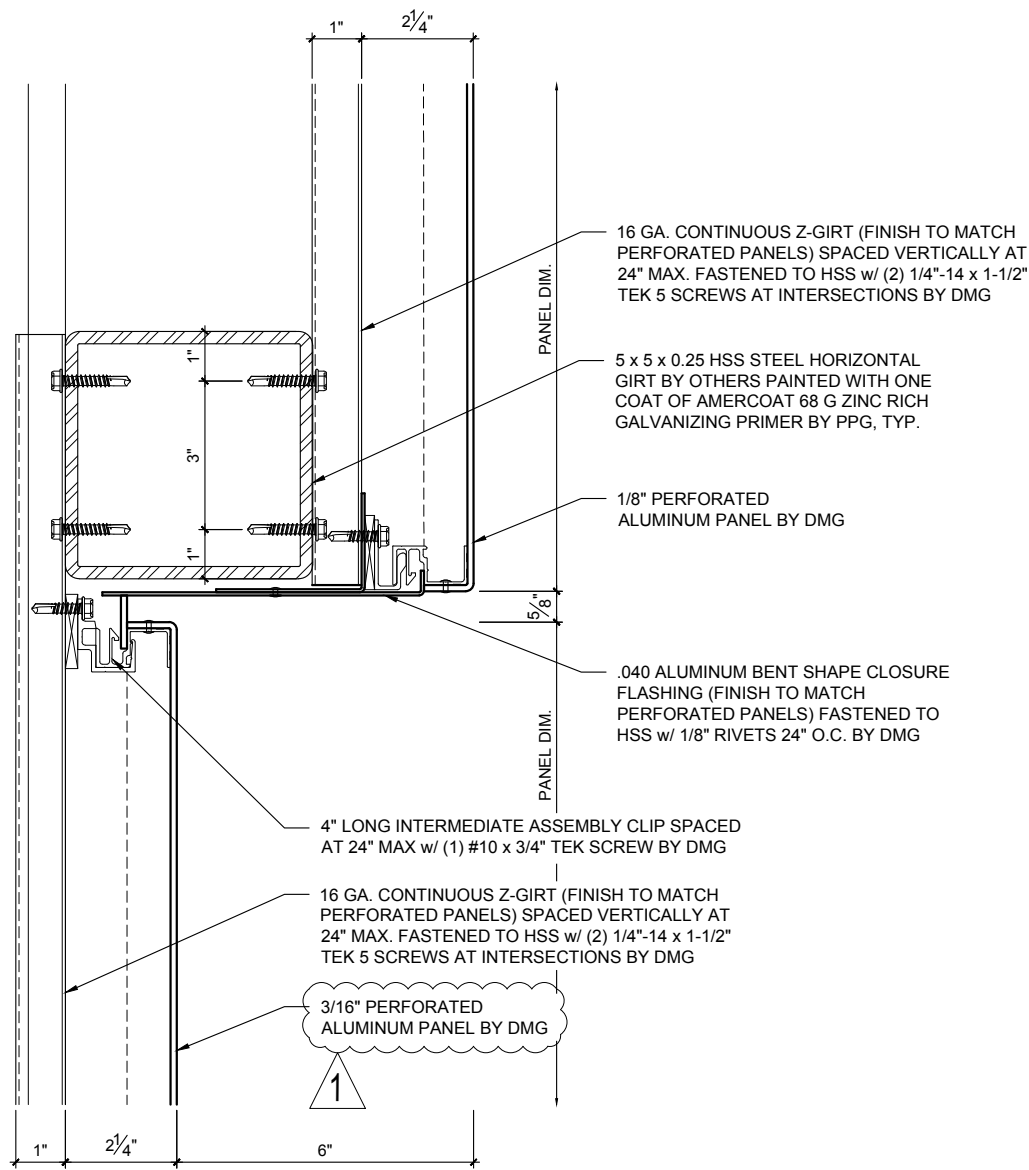

8 INT. HORIZONTAL: RECESS
403 SCALE: 3" = 1'-0"

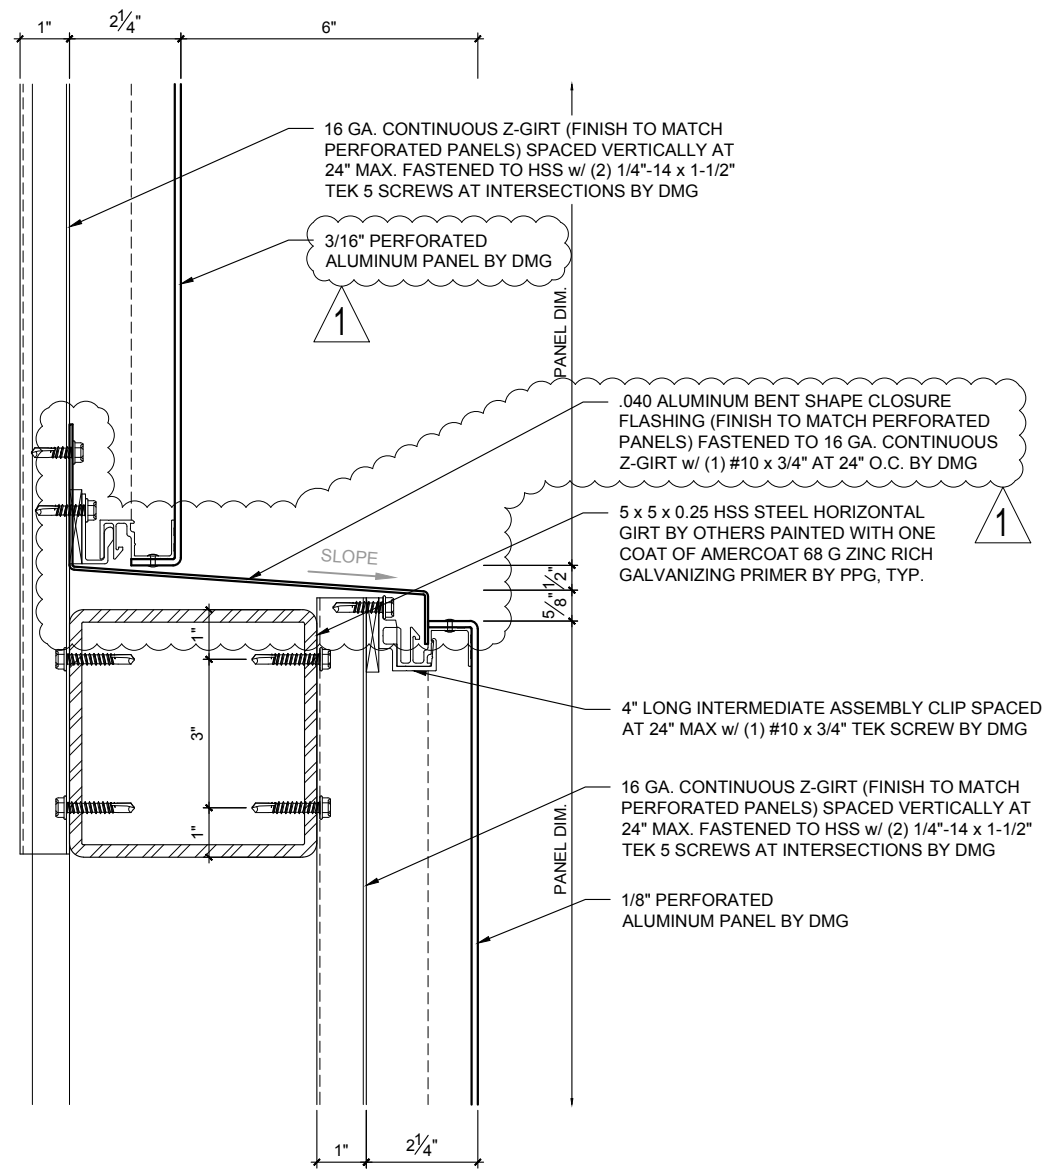

9 INT. HORIZONTAL: RECESS
403 SCALE: 3" = 1'-0"

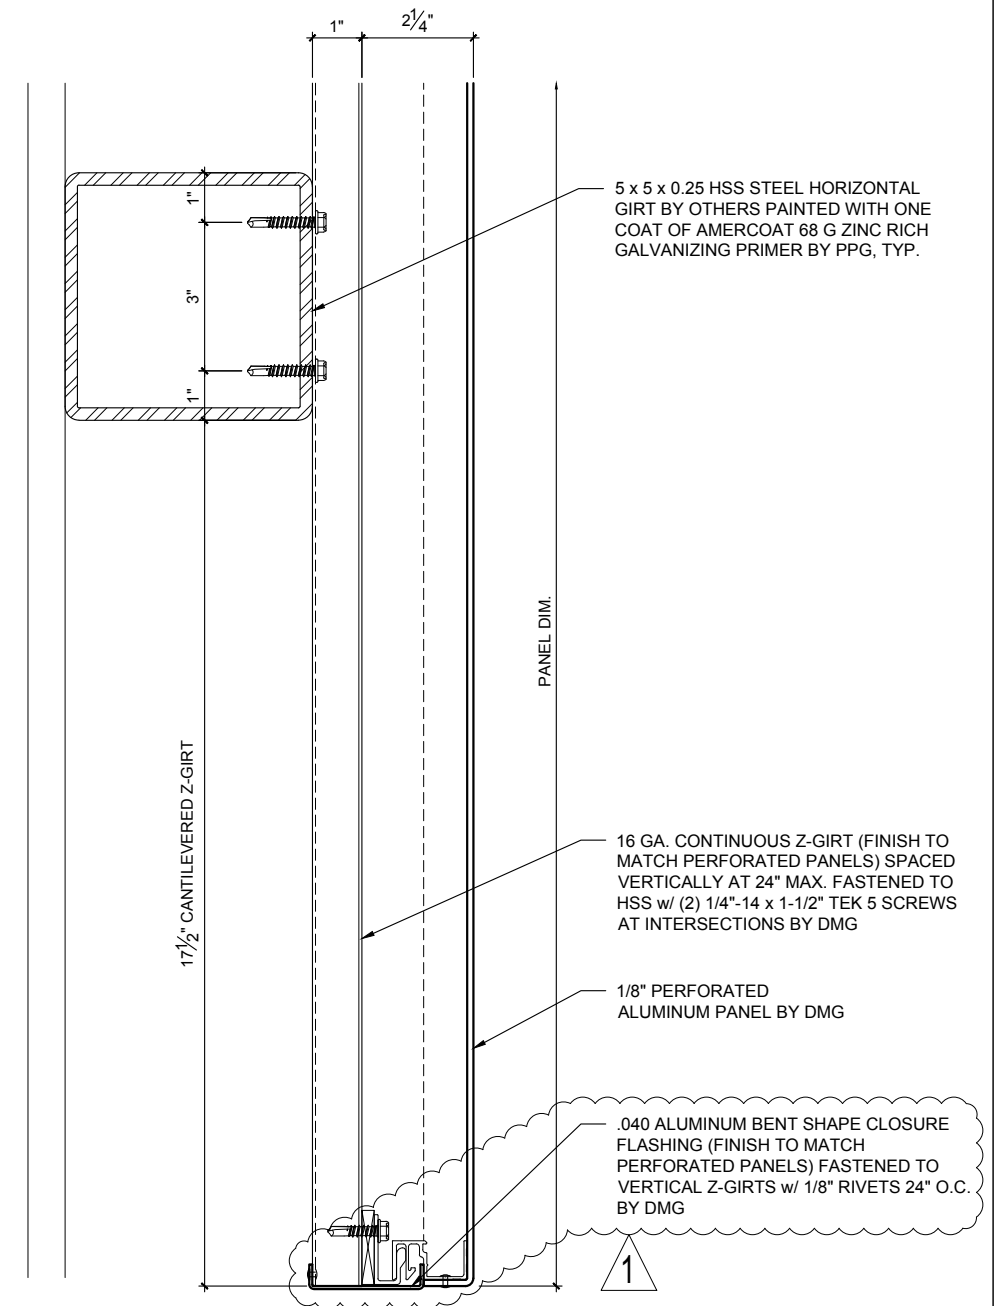

10 BOTTOM DRY JOINT DETAIL
403 SCALE: 3" = 1'-0"



No.	REVISION	BY	DATE
1	REVISIONS AS PER ARCH MARK-UPS	TJP	04.30.19

DMG
architectural glass & metal

357 CROFT DRIVE
TECUMSEH, ON N8N 2L9 TEL: (519) 735-0093
FAX: (519) 735-0075

DRAWING NAME: PANEL DETAILS

JOB NAME: TUNNEL DUTY FREE RENOVATIONS


ADDRESS: 465 GOYEAU ST, WINDSOR, ONTARIO

ARCHITECT: JP THOMSON ARCHITECTS LTD


CONTRACTOR: PCR CONTRACTORS INC

SCALE: 3/16"=1'-0" DRAWN BY: TJP CAD FILE: SHEET No. 403


CHKD BY: RJM DATE: 02.22.2019 JOB N.: 1187

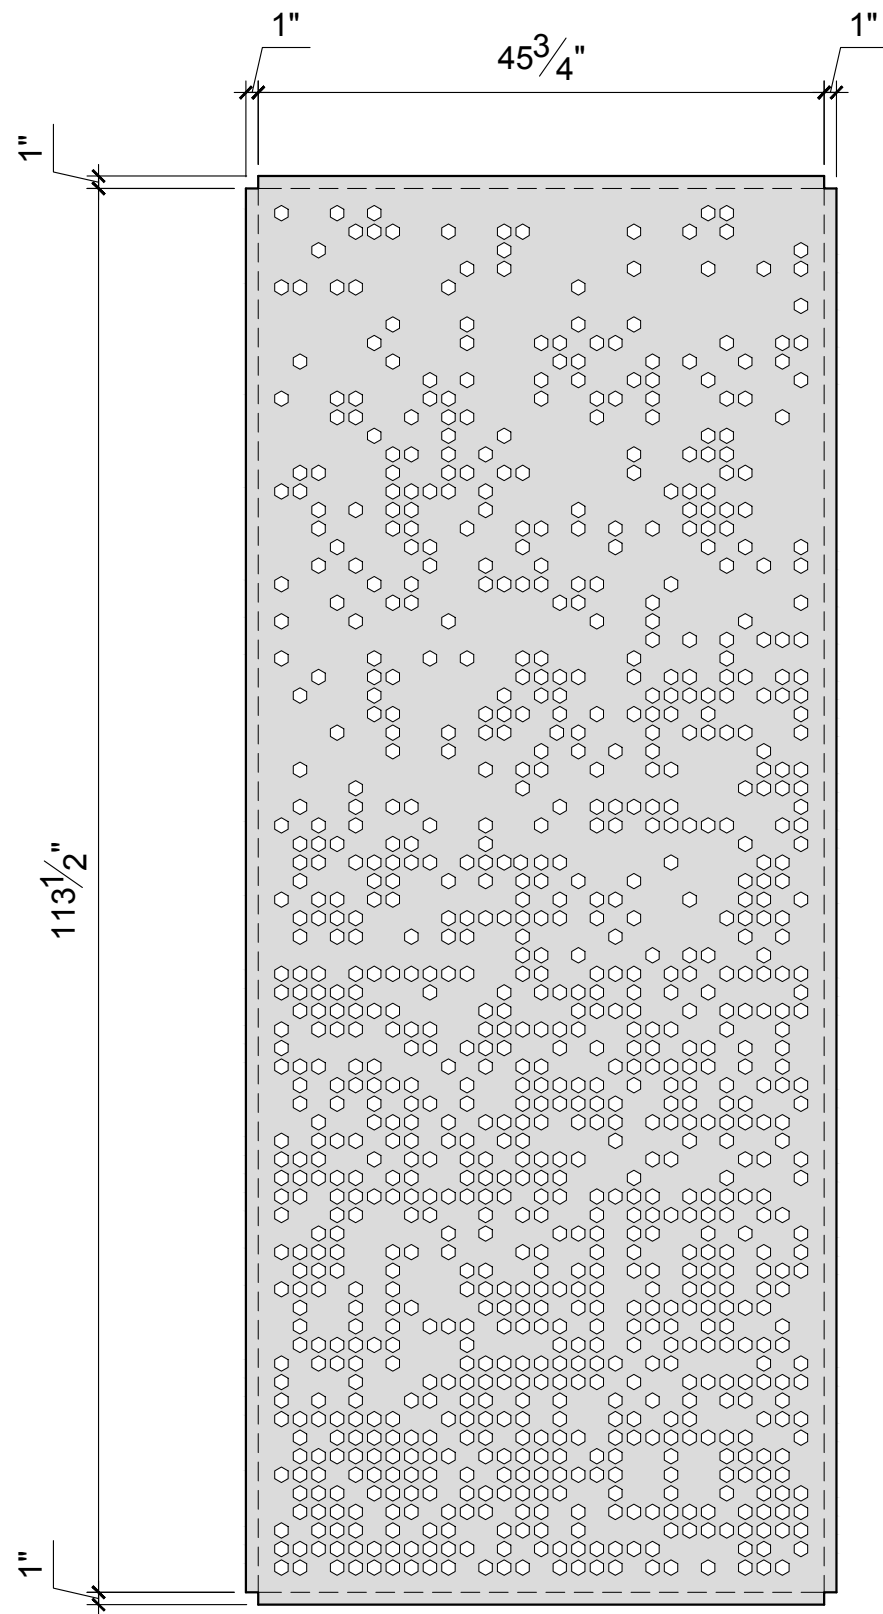

TYPE 'A' - 1/8" ALUMINUM PANEL
QTY: 44

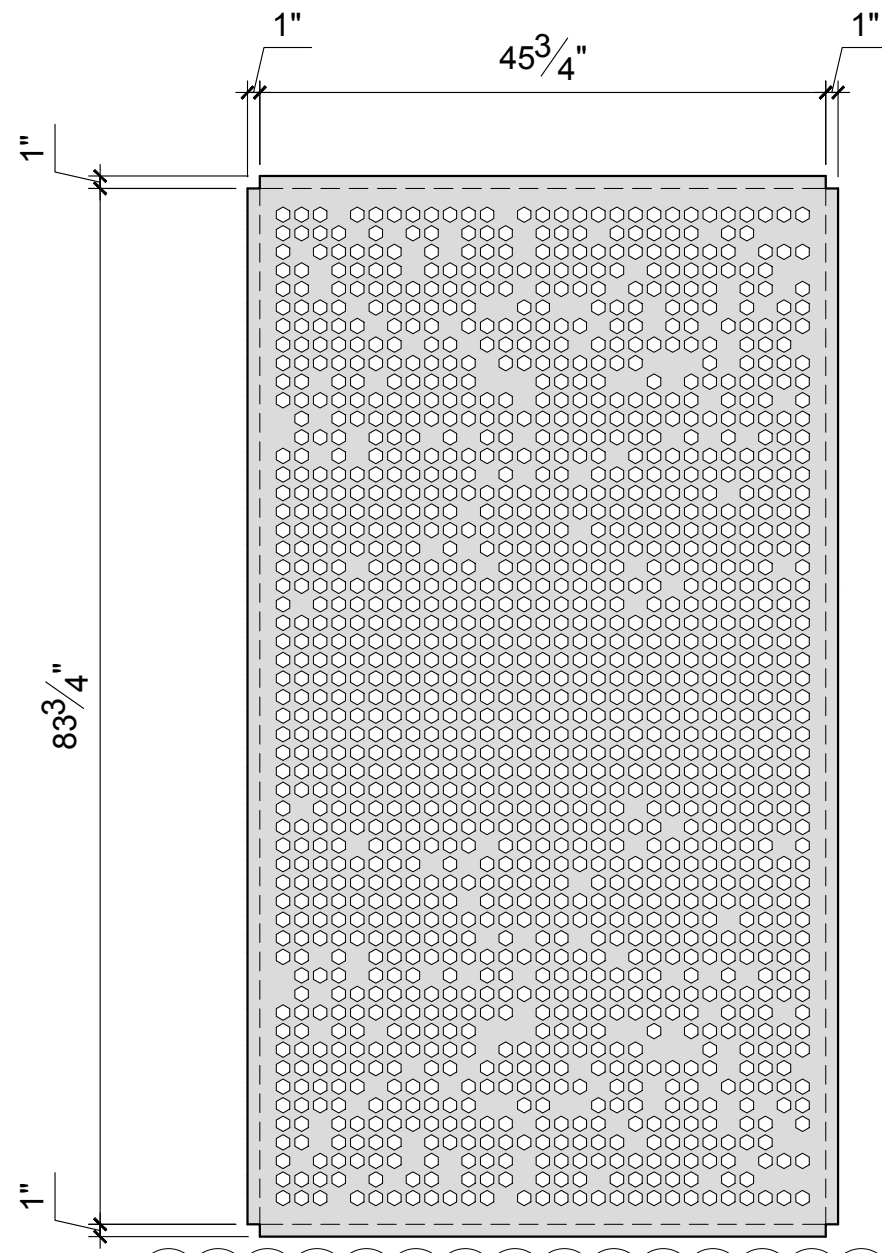

TYPE 'B' - 3/16" ALUMINUM PANEL
QTY: 8

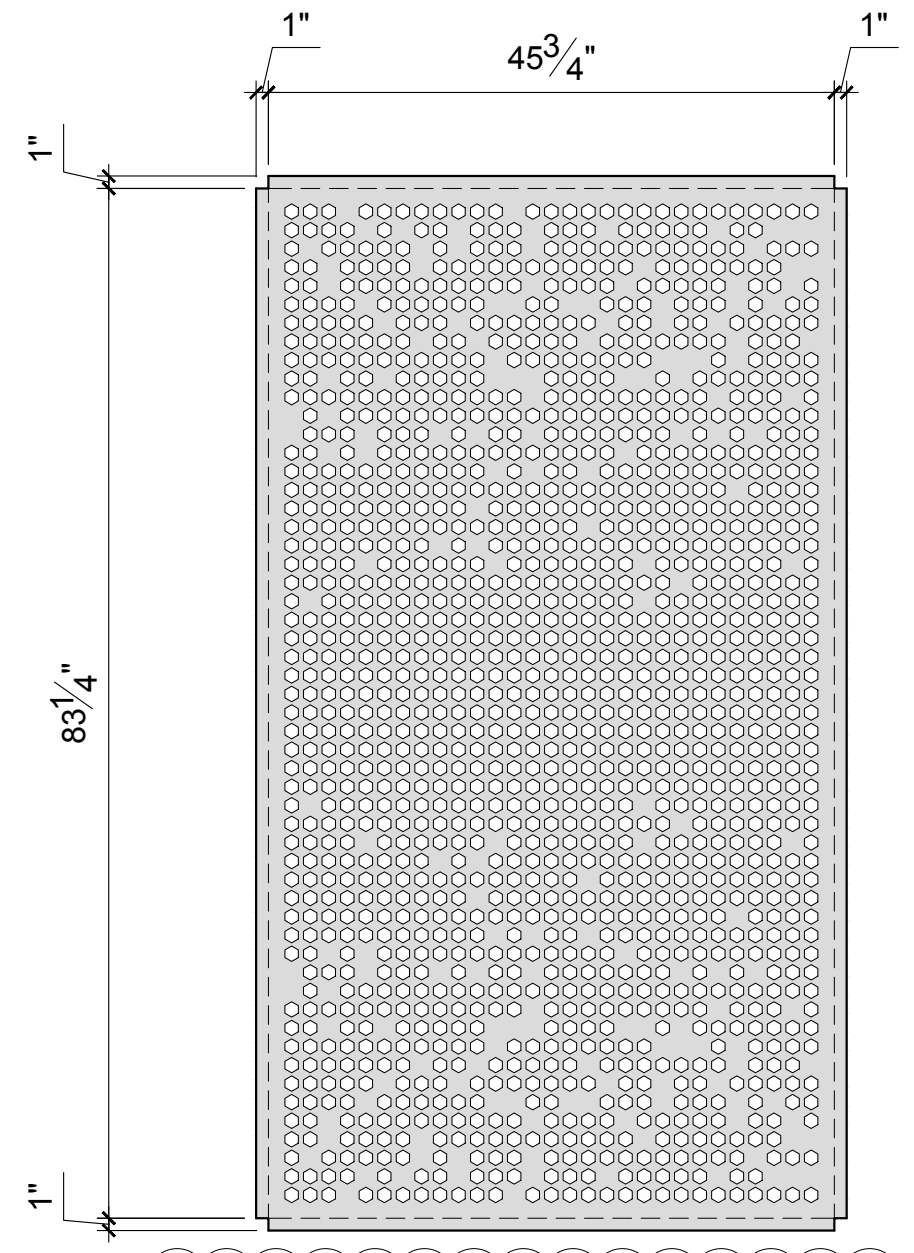


TYPE 'C' - 3/16" ALUMINUM PANEL
QTY: 16

TYP
501

TYP. PERFORATED PANELS w/ CUSTOM HEXAGONAL HOLES
SCALE: 3/4" = 1'-0"



No.	REVISION	BY	DATE
1	REVISIONS AS PER ARCH MARK-UPS	TJP	04.30.19


 357 CROFT DRIVE TECUMSEH, ON N8N 2L9 TEL: (519) 735-0093 FAX: (519) 735-0075
 DRAWING NAME: TYPICAL PANEL PATTERN
 JOB NAME: TUNNEL DUTY FREE RENOVATIONS
 ADDRESS: 465 GOYEAU ST, WINDSOR, ONTARIO
 ARCHITECT: JP THOMSON ARCHITECTS LTD
 CONTRACTOR: PCR CONTRACTORS INC
 SCALE: 3/16"=1'-0" DRAWN BY: TJP CAD FILE: SHEET No.:
 CHKD BY: RJM DATE: 02.22.2019 JOB N.: 1187 501